

JOINT
PUBLIC NOTICE

CHARLESTON DISTRICT, CORPS OF ENGINEERS
69A Hagood Avenue
Charleston, South Carolina 29403-5107
and
THE S.C. DEPARTMENT OF HEALTH AND ENVIRONMENTAL CONTROL
Office of Environmental Quality Control
Water Quality Certification and Wetlands Programs Section
2600 Bull Street
Columbia, South Carolina 29201

REGULATORY DIVISION
Refer to: P/N #2005-1E-377-C

4 November 2005

Pursuant to Section 10 of the Rivers and Harbors Act of 1899 (33 U.S.C. 403), Section 401 of the Clean Water Act (33 U.S.C. 1344), the South Carolina Coastal Zone Management Act (48-39-10 et seq.), and the S.C. Construction in Navigable Waters Permit Program (R. 19-450, et seq., 1976 S.C. Code of Laws, as amended), an application has been submitted to the Department of the Army and the S.C. Department of Health and Environmental Control by

CHARLES R. ADAMS
1590 SPRINGPOINT ROAD, APT. C
ROCK HILL, SOUTH CAROLINA 29732-9555

for a permit to excavate and modify an existing permitted dock structure in the

ATLANTIC INTRACOASTAL WATERWAY (AIWW)

at Tract 4, Waterside Street, Forest Lakes Subdivision, North Myrtle Beach, Horry County, South Carolina.
(Latitude – 33.8298; Longitude -78.6935)

In order to give all interested parties an opportunity to express their views

NOTICE

is hereby given that written statements regarding the proposed work will be received by both of the above mentioned offices until

12 O'CLOCK NOON, MONDAY, 21 NOVEMBER 2005

from those interested in the activity and whose interests may be affected by the proposed work.

The proposed work consists of excavating approximately 110 cubic yards of material from the site of the existing structure. The excavated material will be transported to an upland disposal area. In addition, the applicant also proposes to construct a 14' x 27' covered boat lift on the upstream side of the existing fixed pierhead authorized by DA Permit #96-1E-175. A 10' x 10' floating dock is proposed on the downstream side of the fixed pierhead and attached to a 4' x 17.75' walkway leading from the existing walkway by a 3' wide ramp. It is understood that this work will be conducted on/or adjacent to an area subject to a prism and/or disposal easement held by the United States in perpetuity in conjunction with a Congressionally authorized project for the maintenance and improvement of the Atlantic Intracoastal Waterway. Should a permit be issued, appropriate provisions will be included to ensure the interests of the Federal Government are understood. The purpose of the excavation is to allow navigable depths for the applicant's private recreational boating access to the AIWW.

NOTE: Plans depicting the work described in this notice are available and will be provided, upon receipt of a written request, to anyone that is interested in obtaining a copy of the plans for the specific project. The request must identify the project of interest by public notice number and a self-addressed stamped envelope must also be provided for mailing the drawings to you. Your request for drawings should be addressed to the

**U.S. Army Corps of Engineers
ATTN: REGULATORY DIVISION
69A Hagood Avenue
Charleston, South Carolina 29403-5107**

The District Engineer has concluded that the discharges associated with this project, both direct and indirect, should be reviewed by the South Carolina Department of Health and Environmental Control in accordance with provisions of Section 401 of the Clean Water Act. As such, this notice constitutes a request, on behalf of the applicant, for certification that this project will comply with applicable effluent limitations and water quality standards. The work shown on this application must also be certified as consistent with applicable provisions of the Coastal Zone Management Program (15 CFR 930). The District Engineer will not process this application to a conclusion until such certifications are received. This activity may also require evaluation for compliance with the S.C. Construction in Navigable Waters Permit Program. State review, permitting and certification is conducted by the S.C. Department of Health and Environmental Control. The applicant is hereby advised that supplemental information may be required by the State to facilitate the review. Persons wishing to comment or object to State certification or the navigable waters permit must submit all comments in writing to the S.C. Department of Health and Environmental Control at the above address within thirty (30) days of the date of this notice.

This notice initiates the Essential Fish Habitat (EFH) consultation requirements of the Magnuson-Stevens Fishery Conservation and Management Act. Implementation of the proposed project would impact 0.06 acre of estuarine substrates and emergent wetlands utilized by various life stages of species comprising the red drum, shrimp, and snapper-grouper management complexes. Our initial determination is that the proposed action would not have a substantial individual or cumulative adverse impact on EFH or fisheries managed by the South Atlantic Fishery Management Council and the National Marine Fisheries Service (NMFS). Our final determination relative to project impacts and the need for mitigation measures is subject to review by and coordination with the NMFS.

The District Engineer has consulted the latest published version of the National Register of Historic Places for the presence or absence of registered properties, or properties listed as being eligible for inclusion therein, and this worksite is not included as a registered property or property listed as being eligible for inclusion in the Register. Consultation of the National Register constitutes the extent of cultural resource investigations by the District Engineer, and he is otherwise unaware of the presence of such resources. Presently unknown archaeological, scientific, prehistorical, or historical data may be lost or destroyed by the work to be accomplished under the requested permit.

Any person may request, in writing, within the comment period specified in this notice, that a public hearing be held to consider this application. Requests for a public hearing shall state, with particularity, the reasons for holding a public hearing.

4 November 2005


The decision whether to issue a permit will be based on an evaluation of the probable impact including cumulative impacts of the activity on the public interest. That decision will reflect the national concern for both protection and utilization of important resources. The benefit which reasonably may be expected to accrue from the project must be balanced against its reasonably foreseeable detriments. All factors which may be relevant to the project will be considered including the cumulative effects thereof; among those are conservation, economics, aesthetics, general environmental concerns, wetlands, historic properties, fish and wildlife values, flood hazards, flood plain values, land use, navigation, shoreline erosion and accretion, recreation, water supply and conservation, water quality, energy needs, safety, food and fiber production and, in general, the needs and welfare of the people. A permit will be granted unless the District Engineer determines that it would be contrary to the public interest. In cases of conflicting property rights, the Corps of Engineers cannot undertake to adjudicate rival claims.

The Corps of Engineers is soliciting comments from the public; Federal, state, and local agencies and officials; Indian Tribes; and other interested parties in order to consider and evaluate the impacts of this activity. Any comments received will be considered by the Corps of Engineers to determine whether to issue, modify, condition or deny a permit for this project. To make this decision, comments are used to assess impacts on endangered species, historic properties, water quality, general environmental effects, and the other public interest factors listed above. Comments are used in the preparation of an Environmental Assessment and/or an Environmental Impact Statement pursuant to the National Environmental Policy Act. Comments are also used to determine the need for a public hearing and to determine the overall public interest of the activity.

If there are any questions concerning this public notice, please contact me at 843-329-8044 or toll free at 1-866-329-8187.

A handwritten signature in black ink, appearing to read "Jackie Easterling", with a long horizontal flourish extending to the right.

Jackie Easterling
Project Manager
Regulatory Division
U.S. Army Corps of Engineers

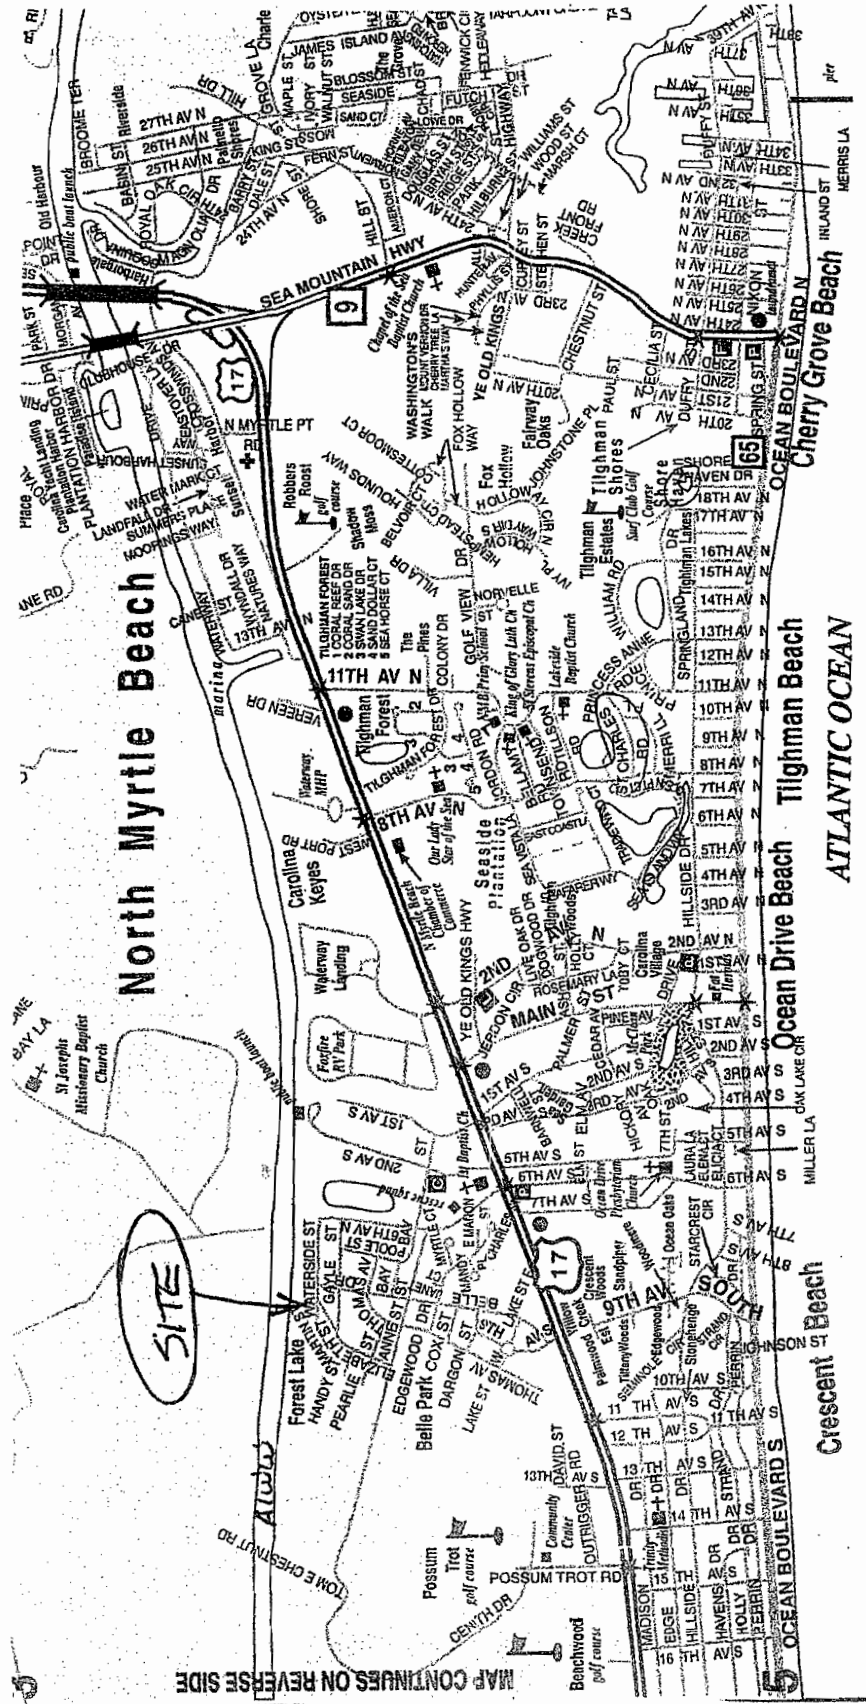

Project Title: PIER STRUCTURE, BOAT
LIFT COVER & FLOATING DOCK

Project Location: TRACT 4
N. MYRTLE BEACH, SC

Applicant:

CHARLES R ADAMS

Date: 10/20/05

Scale: N/A

Application #: 2005-1E-377

Sheet 1 of 3

Revisions
Date Initials

VICINITY MAP



I hereby state to the best of my knowledge, information and belief the survey shown herein was made in accordance with the requirements of the Minimum Standards Manual for the practice of Land surveying in South Carolina, and meets or exceeds the requirements for a Class A survey as specified therein. And there are no encroachments, projections, or easements affecting the property other than those shown.

Randy D. Ward, P.L.S. 17284

May 28th, 2002

DB 562, PG. 567

Location Map

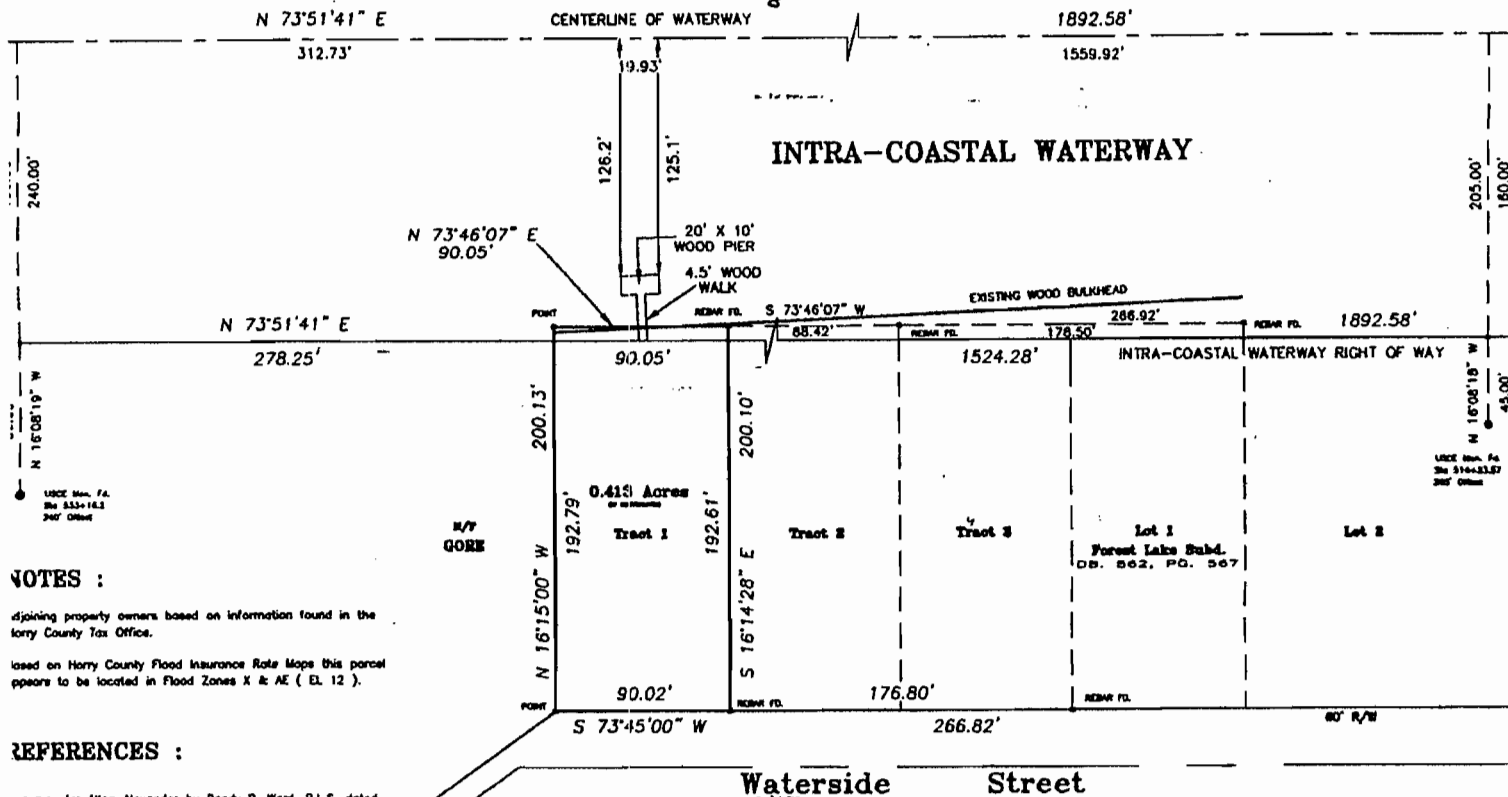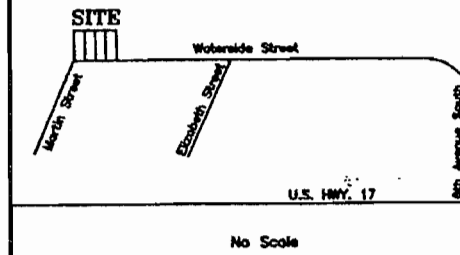

NOTES :

Joining property owners based on information found in the Harry County Tax Office.

based on Harry County Flood Insurance Rate Maps this parcel appears to be located in Flood Zones X & AE (D. 12).

REFERENCES :


Survey for Alton Alexander by Randy D. Ward, P.L.S. dated May 4th, 1999 & Revised October 10th, 2000.

96-1D-175
PIER AS-BUILT FOR :

Alton Alexander
Of Tract 1

Little River Township

Harry County, S.C.

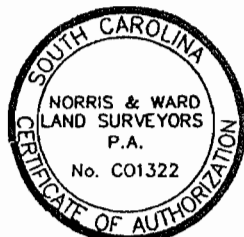

0' 100' 200' 300'



Scale 1" = 30'

May 28th, 2002

© Norris & Ward Land Surveyors, P.A. 2002

2006-1E-377

Sheet 1A of 3



Steve M. Norris, P.L.S.
Randy D. Ward, P.L.S.

NORRIS & WARD
Land Surveyors, P.A.

1301 Thomasboro Rd. SW, Calabash, N.C. 28467

(910) 579-5808
(910) 201-1125

SC #
(843) 280-8836

(910) 579-5825
Fax

Surveyed By: RW, BI, BC

File # 011210A

Drawn By: HS


Tax Map# 144-05-01

Checked By: RW

Parcel #

WO# 0112-10

FB. 130, PG. 79

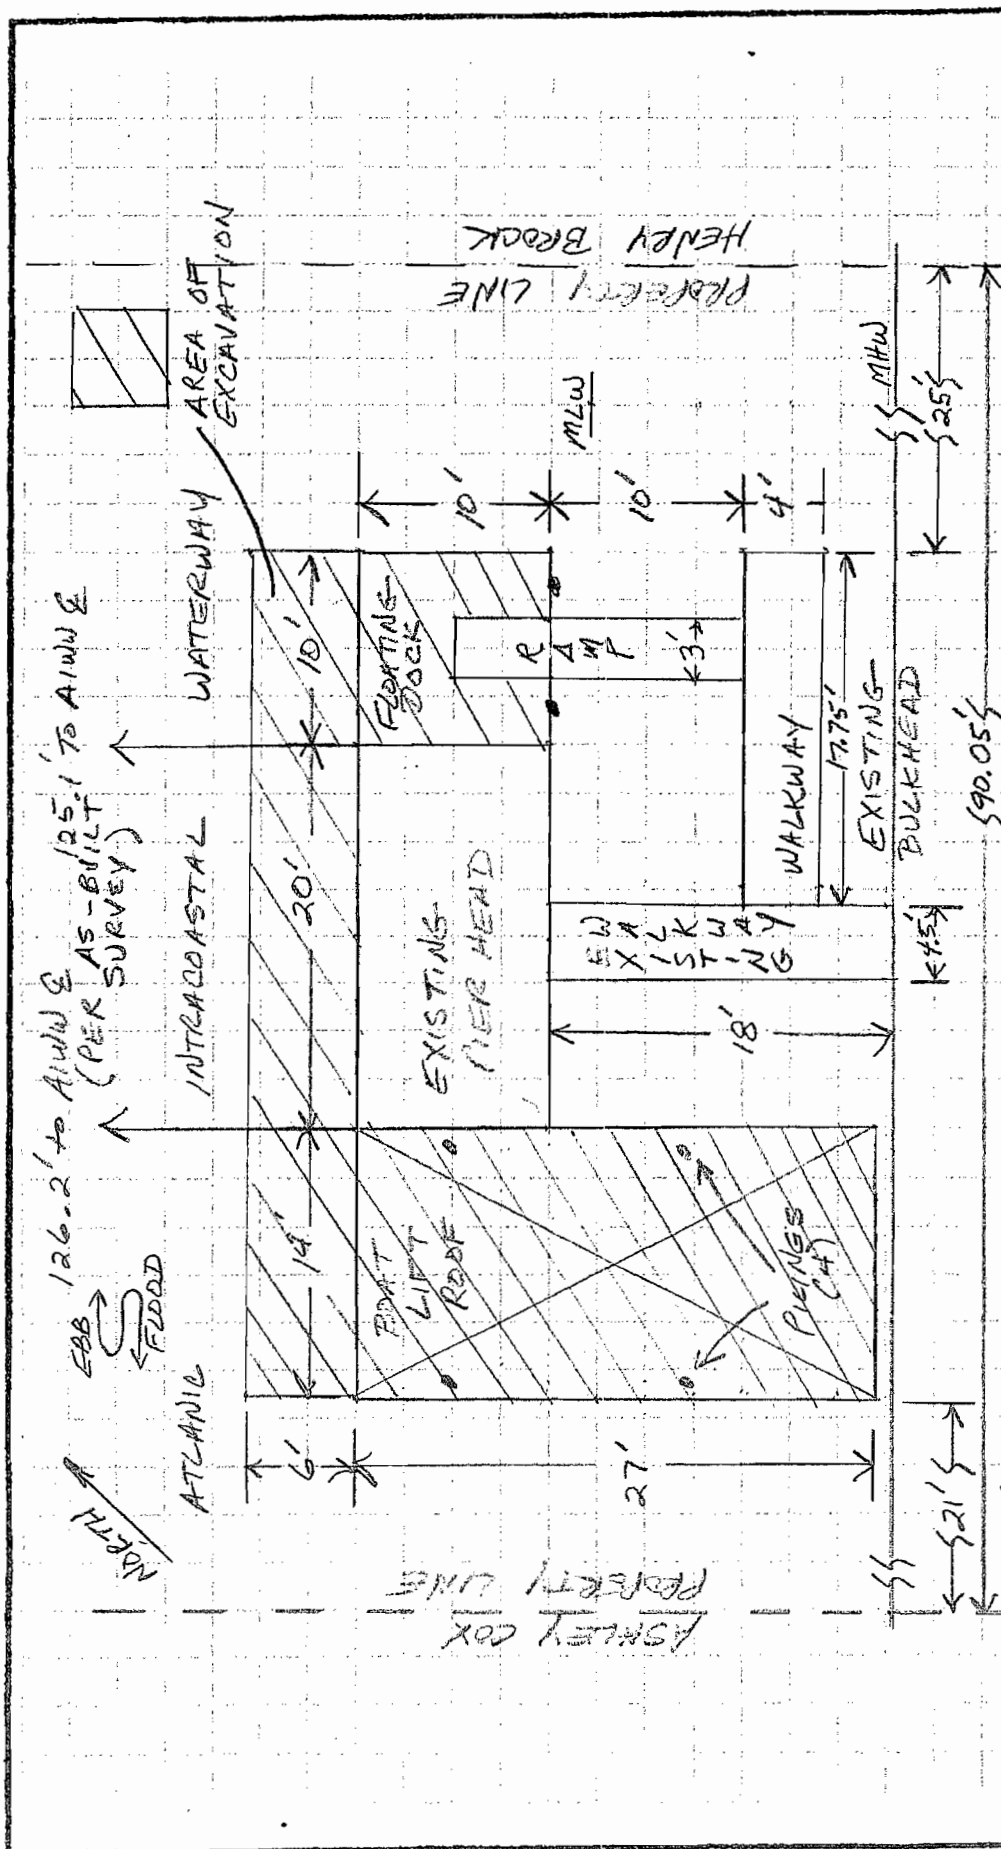


PLAN VIEW

1" = 10 FT

NOTE: The controlling dimension for structures on the AIWW is the distance from the waterward end of the structure to the centerline of the AIWW. The controlling dimension for this structure is 125'.

Project Title: PIER STRUCTURE, BOAT LIFT COVER + FLOATING DOCK	
Project Location: TRACT 4 WATERSIDE ST N. MYRTLE BEACH, SC	
Applicant: CHARLES R ADAMS	
Date: 10/20/05	Scale: 1" = 10'
Application #: 8005-1E-377	Sheet of 3

Revisions	
Date	Initials

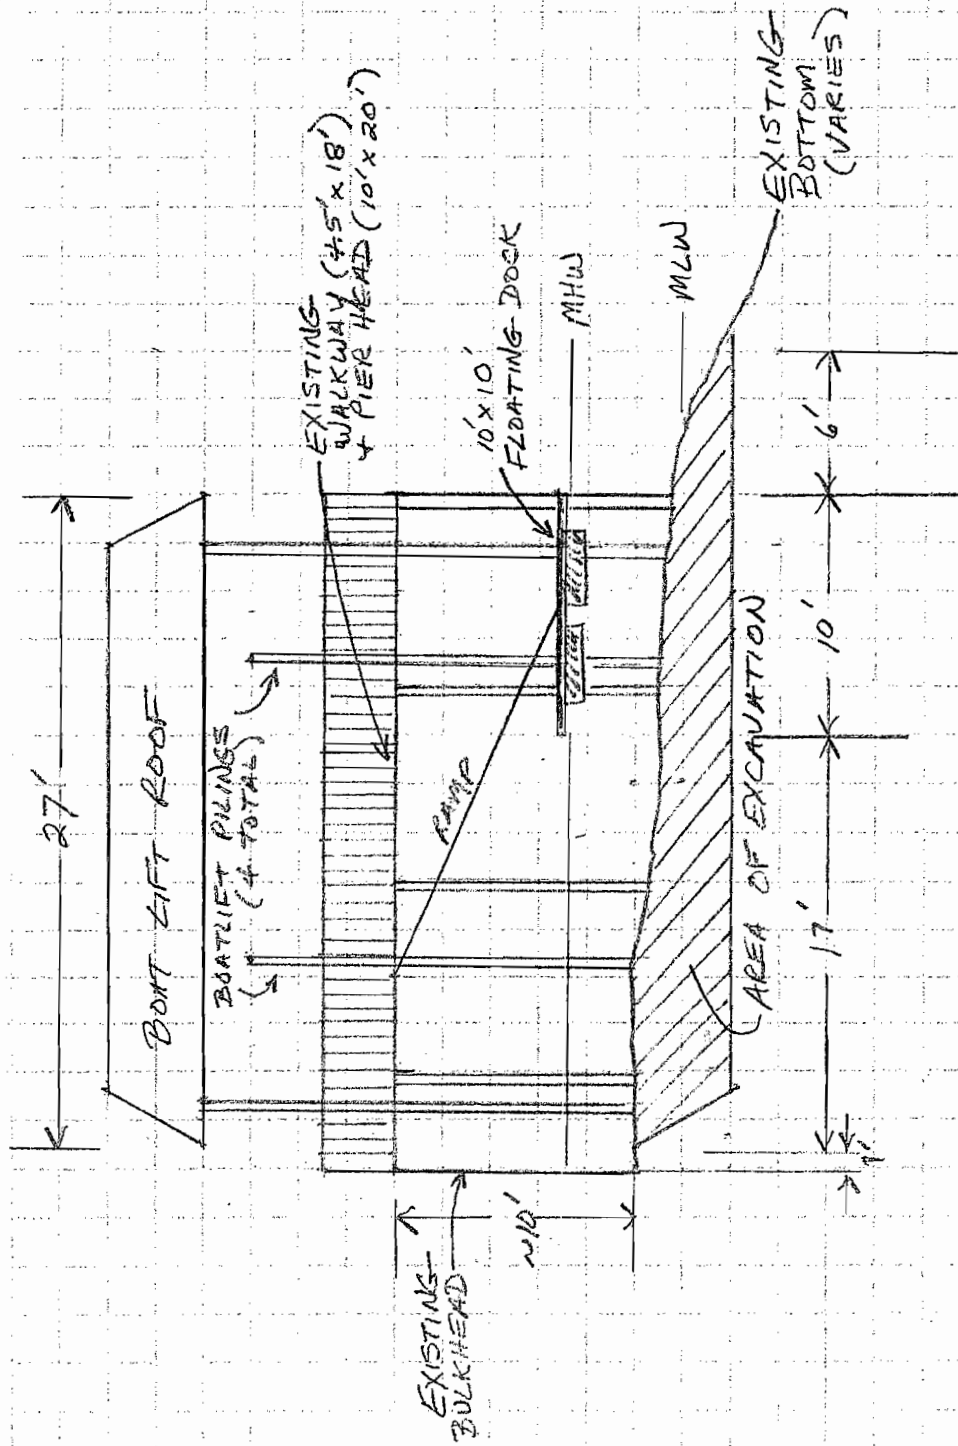

ELEVATION VIEW

1 IN = 8 FT

NOTE: Excavated material, approximately 110 cubic yards, to be transported to an upland disposal rea.

Project Title: PIER STRUCTURE, BOAT LIFT COVER & FLOATING DOCK	
Project Location: TRACT 4, WATERSIDE ST., MYRTLE BEACH, SC	
Applicant: CHARLES R. ADAMS	
Date: 10/20/05	Scale: 1" = 8'
Application #: 2005-16-377	Sheet of 3

Revisions	
Date	Initials